



# Addendum No. 4 Receipt Certification

Project	Pump Station Upgrade Program Walden Woods, Jefferson Valley and Jefferson Park	Project No.	8618742
Owner	Town of Yorktown, New York	Date	February 27, 2018

***Each Addendum Receipt Certification is to be submitted with the bid.  
Failure to submit the Addendum Receipt Certification  
may result in rejection of the bid.***

I, \_\_\_\_\_, certify that I have received Addendum No. 4 consisting of one page for the Pump Station Upgrade Program, Walden Woods, Jefferson Valley and Jefferson Park, Bid #16-5 Rev, and acknowledge all terms, conditions and modifications to the bid documents.

---

Bidder (Company)

---

Authorized Signer (Print)

---

Signature



## Addendum No. 4 to Contract Documents

Project	Pump Station Upgrade Program Walden Woods, Jefferson Valley and Jefferson Park	Project No.	8618742
Owner	Town of Yorktown, New York		
Contract No.	1 – General 2 – Electrical	Date	February 27, 2018

To All Contractors:

Contractors submitting proposals for the above-named project shall take note of the following changes, additions, deletions, clarifications, etc., in the Contract Documents, which shall become a part of and have precedence over anything contrarily shown or described in the Contract Documents, and all such shall be taken into consideration and be included in the Contractor's bid proposal.

Item No. 1:

**ADD** the attached two-page boring log (Attachment No. 1) to Exhibit E of the Agreement.

Item No. 2:

Contract Drawings, Sheets JV-M002 & JV-M003. At every occurrence, **DELETE** "restrained flange adapters" and **REPLACE** with "6-inch flexible connection."



  
Robert Butterworth, P.E.


<b>SOILTESTING, INC.</b> 90 DONOVAN RD. OXFORD, CT 06478 CT (203) 262-9328 NY (914) 946-4850	CLIENT: <b>GHD Consulting Services</b>	SHEET <u>1</u> OF <u>1</u>
	PROJECT NO. <b>G148-0101-15</b>	HOLE NO. <b>BJP-1</b>
	PROJECT NAME <b>Proposed Jefferson Park Pump Station</b>	BORING LOCATIONS per Plan
FOREMAN - DRILLER <b>TP/ad</b>	LOCATION <b>Juniper Drive Yorktown, NY</b>	
INSPECTOR	CASING TYPE <b>HSA</b>	SAMPLER <b>SS</b>
GROUND WATER OBSERVATIONS AT <u>10</u> FT AFTER <u>0</u> HOURS AT <u>3'10"</u> FT ON <u>7-7-15</u>	SIZE I.D. <b>4 1/4"</b>	CORE BAR <b>BIT</b>
	HAMMER WT.	OFFSET
	HAMMER FALL	DATE START <b>6/26/15</b>
		DATE FINISH <b>6/25/15</b>
		SURFACE ELEV.
		GROUND WATER ELEV.

DEPTH	CASING BLOWS PER FOOT	SAMPLE					BLOWS PER 6 IN ON SAMPLER (FORCE ON TUBE)		CORE TIME PER FT (MIN)	DENSITY OR CONSIST	STRATA CHANGE DEPTH	FIELD IDENTIFICATION OF SOIL REMARKS INCL. COLOR, LOSS OF WASH WATER, SEAMS IN ROCK, ETC.
		NO	Type	PEN	REC	DEPTH @ BOT	0 - 6	6 - 12				
5		1	ss	24"	20"	7'0"	18	7		moist v stiff	10'0"	sm cobbles, boulders  Boulder at 4'  Brn/Gry SILT, sm FM sand, lit FC gravel  Gry SILT, lit FM sand, clay, tr wood, roots ( fill )
10		2	ss	24"	15"	12'0"	9	5		moist/wet loose	11'0"	Brn FMC SAND, sm clayey silt, lit F gravel
15		3	ss	24"	14"	17'0"	5	4		wet stiff	15'0"	Gry CLAY lit cobbles from 10 - 11' lit cobbles at 13'
20		4	ss	24"	0"	22'0"	12	13				no recovery
25		5	ss	24"	18"	27'0"	19	22		wet hard		Gry CLAYEY SILT & FMC SAND, lit F GRAVEL
30		6	ss	18"	18"	31'6"	25	46		wet hard	32'0"	SAME AUGER REFUSAL
35												E.O.B. 32'0"
40												Installed 1" SCH 40 PVC observation well to 23' with 10' screen length.


**NOTE: Subsoil conditions revealed by this investigation represent conditions at specific locations and may not represent conditions at other locations or times.**

GROUND SURFACE TO _____ FT. USED _____ CASING THEN _____ CASING TO _____ FT.	HOLE NO. <b>BJP-1</b>
A = AUGER UP = UNDISTURBED PISTON T = THINWALL V = VANE TEST	
WOR = WEIGHT OF RODS WOH = WEIGHT OF HAMMER & RODS	C = COARSE Addendum No. 4
SS = SPLIT TUBE SAMPLER H.S.A. = HOLLOW STEM AUGER	M = MEDIUM Attachment No. 1
PROPORTIONS USED: TRACE = 0 - 10% LITTLE = 10 - 20% SOME = 20 - 35% AND = 35 - 50%	F = FINE

JOB NO.  
**G148-0101-15**  
**SOILTESTING, INC.**  
 90 Donovan Road  
 Oxford, CT 06478

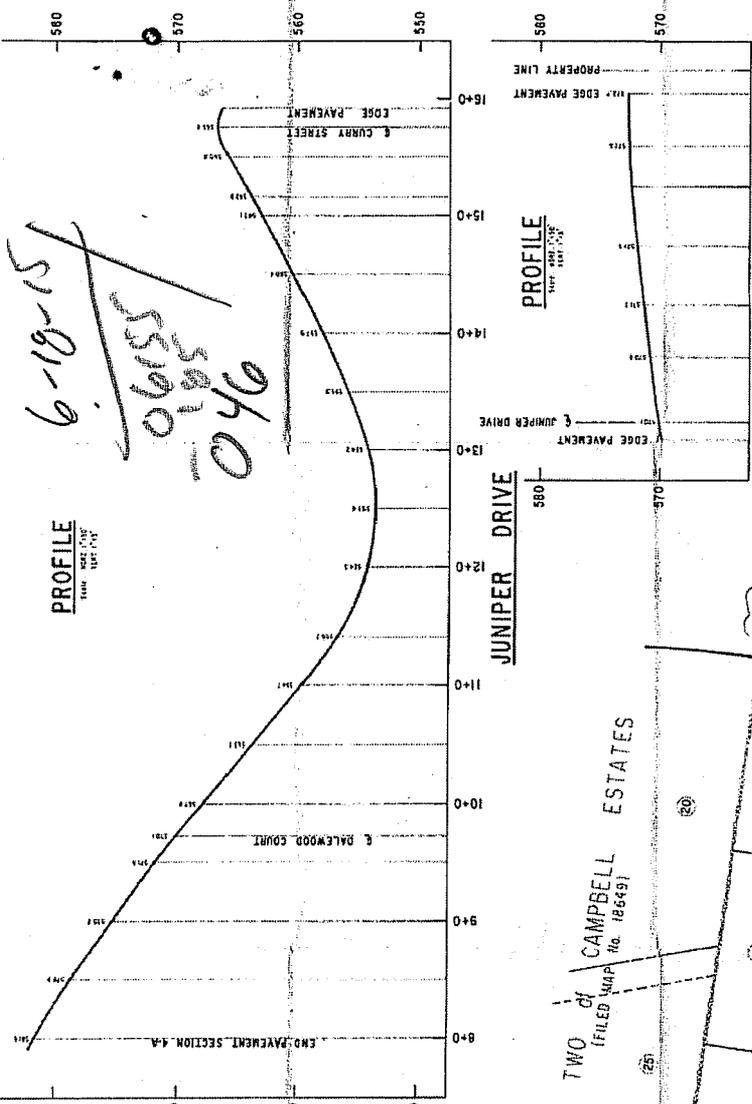

*6-10-15*  
*06855*  
*046*

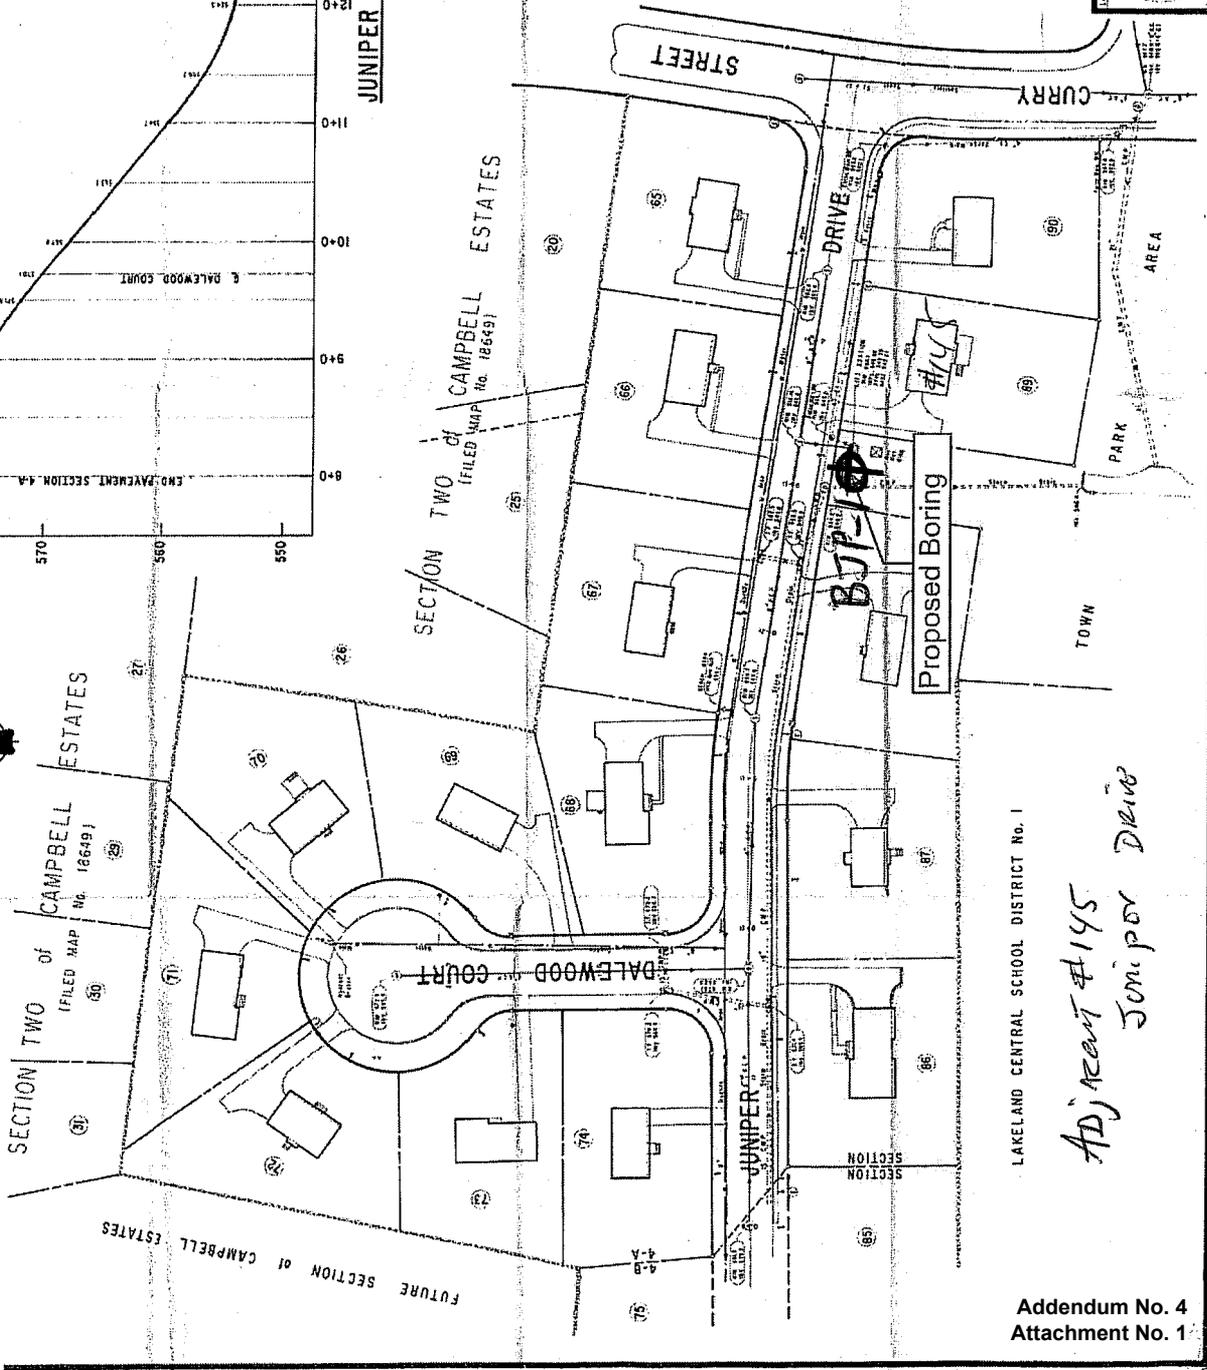

LAKELAND CENTRAL SCHOOL DISTRICT No. 1

*Adjacent #145*  
*Juniper Drive*

Addendum No. 4  
 Attachment No. 1

AS BUILT PLAN  
 OF  
**JEFFERSON PARK - JEFFERSON RIDGE HOMES**  
 SECTION 4-A  
 TOWN OF YORKTOWN, WESTCHESTER COUNTY, N.Y.  
**J. HENRY CARPENTER & CO.**  
 PROFESSIONAL LAND SURVEYING  
 YORKTOWN HEIGHTS, N.Y.



LEGEND  
 1. EXISTING  
 2. PROPOSED  
 3. EASEMENT  
 4. ELEVATION  
 5. DISTANCE  
 6. AREA  
 7. VOLUME  
 8. BEARING  
 9. CURVE DATA  
 10. ADJACENT PROPERTY

DATE: 11/15/14  
 BY: JHC  
 CHECKED: JHC  
 TITLE: AS BUILT PLAN